
SHEET INDEX / PROJECT DIRECTORY AS-BUILT FLOOR PLAN FOR: SHT. NO. **DESCRIPTION COVER SHEET** MELTON LITTLE AS-BUILT FLOOR PLAN 433 8th Avenue West Palmetto, Florida 34221 **SYMBOLS** SECTION/DETAIL REF. DETAIL REF. - DETAIL NO. SECT. LETTER OR DET. NO. TITLE - DWG. TITLE 41.0/ - SHT. NO. SCALE - SCALE DRAWING REVISION INTERIOR EL. REF. ROOM KEY CONTRACTOR, OWNER AND SUBCONTRACTORS ARE RESPONSIBLE FOR YERIFYING THAT THEY HAVE THE LATEST REVISION OF THE PLANS. ALL ENLARGED PLAN REF. **ELEVATION** PREVIOUS REVISIONS OF PLANS ARE VOID AND SHOULD BE DESTROYED REV DATE **DESCRIPTION** DOOR TAG DATE DESCRIPTION SHT. NUMBERING SYSTEM © COPYRIGHT NOTICE RESERVES IT'S COMMON LAW ANI - DWG CATEGORY **FOOTINGS** IRREGATION OTHER COPYRIGHTS IN THESE ARRANGEMENT PLANS, IDEAS, DESIGNS, NOTATION A5.1 INTERIOR DESIGN TABLES AND ANY ELECTRONIC STRUCTURAL MECHANICAL TO BE COPIED OR CHANGED I PLUMBING FIRE PROTECTION SCOPE OF WORK ASSIGNED TO ANY OTHER PARTY WITHOUT FIRST OBTAINING THE EXPRESSED WRITTEN PERMISSION FILLED CELL / ANCHOR NOTES: OF THE FINAL DRAFT INC. **VIOLATIONS WILL BE PROSECUTEI** 1. EXISTING AS-BUILT FLOOR PLAN TO THE FULL EXTENT OF THE ■ INDICATES LOCATION OF (1) CONT. \$ REBAR YERTICAL FROM FOOTING STEEL, W/ HOOK & TIED TO STEEL IN TIE BEAM ABOYE, THEN FILLED SOLID W/ CONCRETE AT 6'-0" O.C. MAX., W/ INSPECTION HOLE AT EA. DOWNPOUR, INDICATES LOCATION OF (2) CONT. *5 OR (1) CONT. *1 REBAR VERTICAL FROM FOOTING STEEL, W/ HOOK & TIED TO STEEL IN TIE BEAM ABOVE, THEN FILLED SOLID W/ CONCRETE SPACED AS SHOWN, W/ INSPECTION HOLE AT EA. DOWNPOUR, UNLESS NOTED OTHERWISE. INDICATES A-30T OR EQUIVALENT 5/8" × 10" STEEL ANCHOR BOLTS, W/ 3" × 3" × 1/8" DIA. WASHERS. PROVIDE (1) ANCHOR BOLT WITHIN 6" TO 12" OF EA. END OF BOTTOM PLATES & WITHIN 12" OF CORNERS. SPACE ANCHORS 18" O.C. FOR EXTERIOR WALLS & 32" O.C. FOR INTERIOR LOAD BEARING WALLS, <u>UNLESS NOTED OTHERWISE.</u> WALL LEGEND MISSED ANCHOR BOLTS MAY BE REPLACED W/ 5/8"X6" SIMPSON TITEN HD BOLT OR 5/8"X10" A.T.R. (ALL THREAD ROD,) SET IN A 3/4"x6" DEEP HOLE IN FOOTING OR CENTER OF FILLED BLOCK CELL, USING SIMPSON SET EPOXY & FOLLOWING ALL EPOXY MFR'S SPECIFICATIONS & RECOMMENDATIONS. RED-HEADS, WEDGE ALL OR EQUIVALENT ANCHORS MAY BE SUBSTITUTED WHEN EMBEDDED 4-1/2". MAX. UPLIFT PER ANCHOR IS 1,650 LB. AT 18" O.C. \$ 2,990 LB. AT 32" O.C. **ABBREVIATIONS** EXISTING BLOCK WALLS EXISTING INTERIOR WALLS Avenue Florida MELTON RISER RADIUS RAFTER ROOF DRAIN REFRIGERATO REMFORCED REQUIRED REVISION ROOM AREA TABULATIONS 433 8th Palmetto, Terra Ceia Rubonia Aquatic COMMERCIAL BUILDING 3,639 S.F. Preserve 3,639 S.F. (301) INFORMATION INSULATION INTERIOR TIE BEAM TOP OF CURB TONGUE AND GROOVE THRESHOLD TOP OF BEAM TOP OF PLATE TOILET PAPER HOLDER TRANSOM TREAD TYPICAL TEXTURED 433 8th Ave W, CLIENT, BUILDER AND SUBCONTRACTORS SHALL REVIEW ENTIRE PLANS, CHECKING ALL DIMENSIONS, BEARING HEIGHT6, BEAM SIZES, WINDOW SIZES, ETC... IF THERE ARE ANY DISCREPANCIES OR QUESTIONS Palmetto, FL 34221 NOTIFY THE BUILDER OR HIS AGENT IMMEDIATELY BEFORE PROCEEDING! Palma Sola FINAL DRAFT <u>WILL NOT</u> ACCEPT ANY BACK CHARGES AND IS NOT RESPONSIBLE FOR ANY ERRORS, OMISSIONS OR CUSTOM CHANGES MISSED AND NOT REPORTED TO THIS OFFICE PRIOR TO PERMITTING, CONSTRUCTION AND/OR MATERIAL PROCUREMENT. THESE PLANS, SPECIFICATIONS AND DETAILS ARE FOR THE EXPRESSED USE OF THIS PROJECT ONLY. DETAIL DIAMETER DOUN DINING DOOR DOUN SPOU DISPOSAL DISHWASHER DRAWER REPRODUCTION, RE-USE, COPING OR REVISING OF THIS INFORMATION OR USE ON ANY OTHER PROJECT WITHOUT THE EXPRESSED WRITTEN APPROVAL OF FINAL DRAFT INC. IS PROHIBITED. MET. MFR. MIC. WV. MIN. MONO. THESE DOCUMENTS ARE NOT ARCHITECTURAL, INTERIOR DESIGN, OR ENGINEERING DESIGNS, 7/7/2021 SPECIFICATIONS OR LAYOUTS AND ARE NOT TO BE USED FOR CONSTRUCTION UNLESS REVIEWED AND REVISION: 7/21/2021 APPROVED BY A LICENSED DESIGN PROFESSIONAL EXCEPT AS OTHERWISE PROVIDED BY LAW. VOLT VARIOUS VERTICAL VISUAL VOLUMN EACH EMERGENCY ESCAPE RESCUE OPENING ELECTRICAL ELEVATION South AS SHOWN 2K21101R1 WASHER WEDGE ANCHOR WOOD WINDOW WROUGHT IRON WALK IN CLOSET SHEET Bayshore VICINITY MAP KEY PLAN © COPYRIGHT 2020

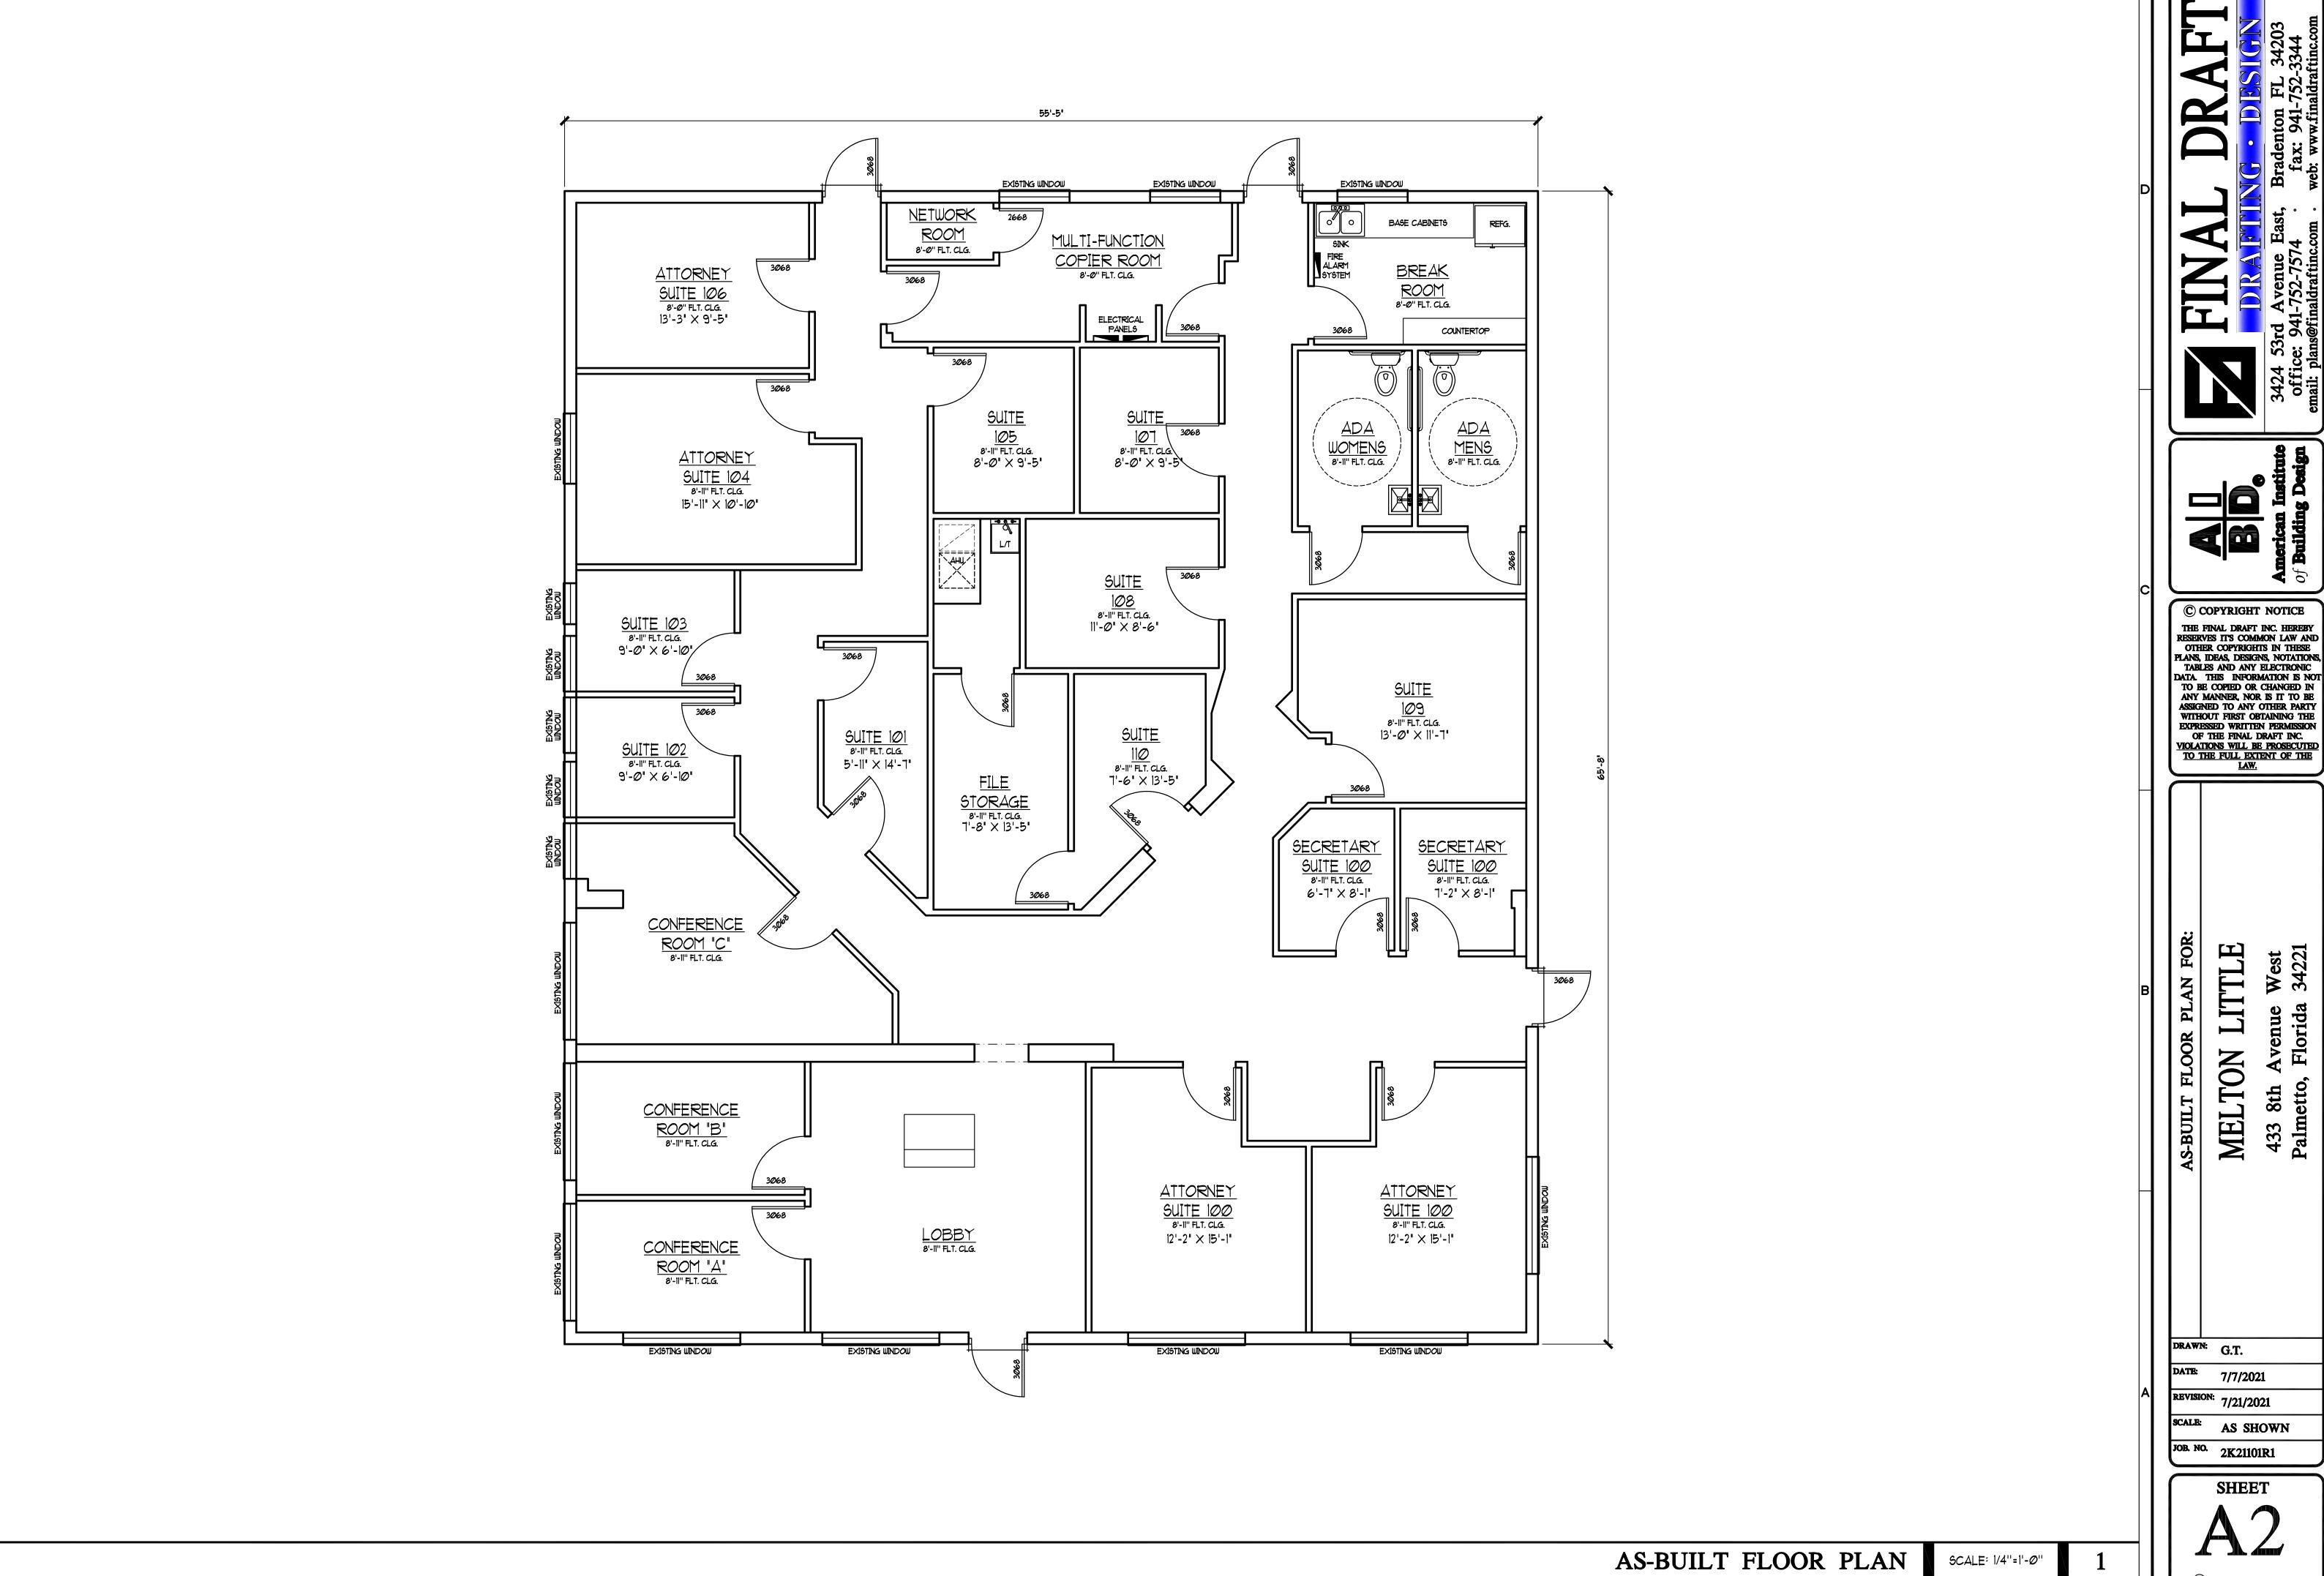

DATA. THIS INFORMATION IS NOT TO BE COPIED OR CHANGED IN ANY MANNER, NOR IS IT TO BE ASSIGNED TO ANY OTHER PARTY WITHOUT FIRST OBTAINING THE EXPRESSED WRITTEN PERMISSION
OF THE FINAL DRAFT INC.
VIOLATIONS WILL BE PROSECUTED
TO THE FULL EXTENT OF THE
LAW.

Avenue, Florida

433 8th A

REVISION: 7/21/2021

SCALE: AS SHOWN JOB. NO. 2K21101R1

SHEET