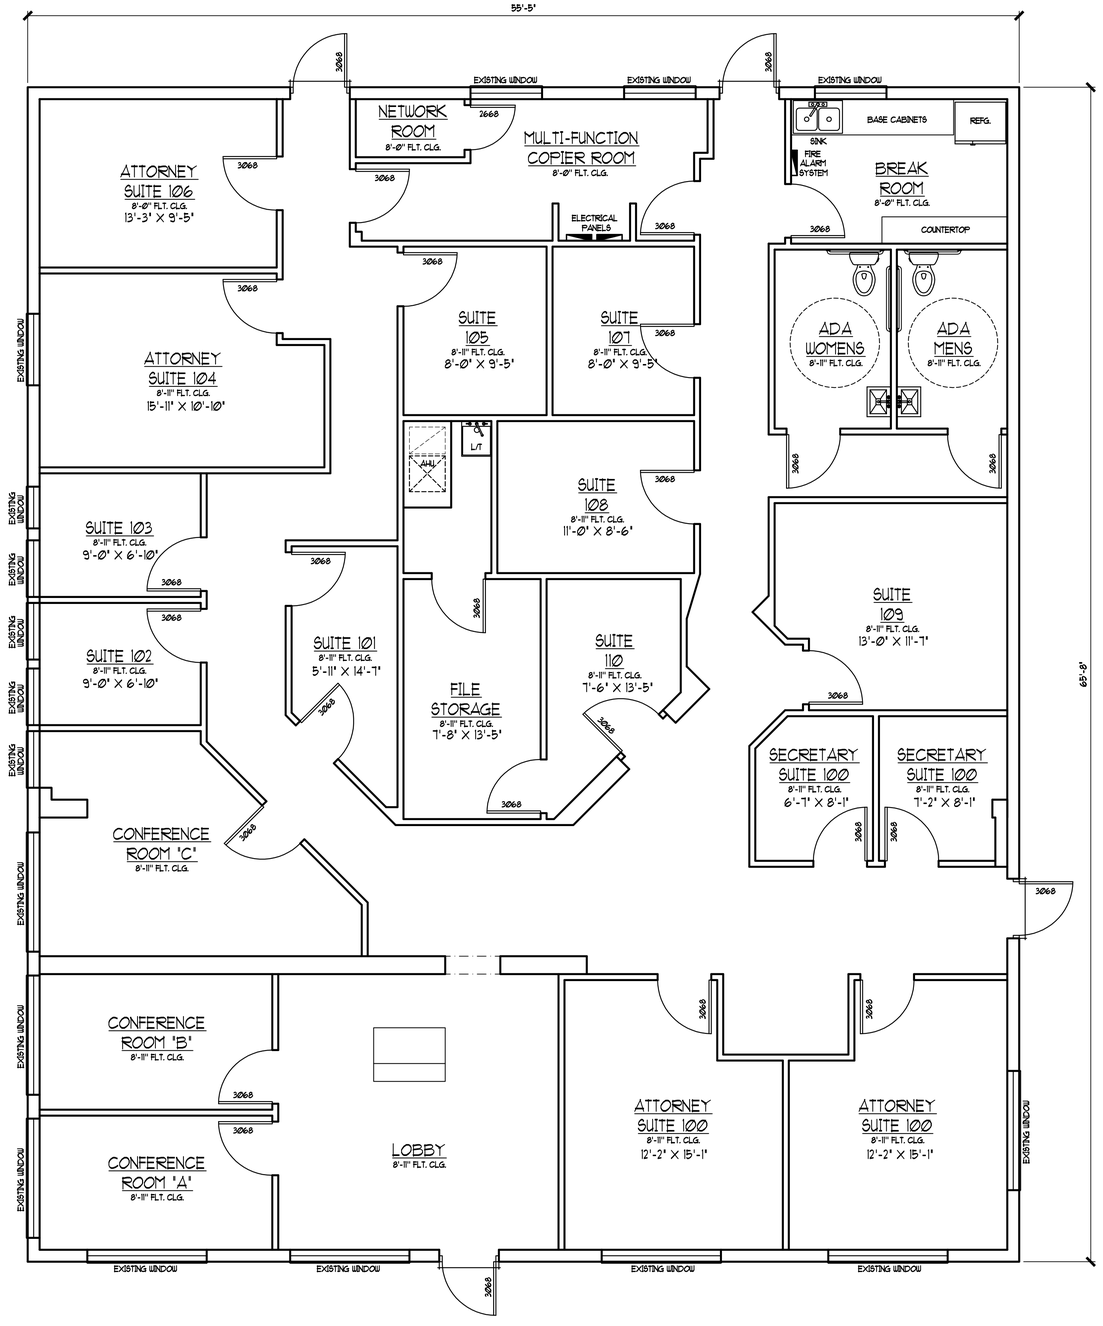

AS-BUILT FLOOR PLAN

SCALE: 1/4"=1'-0"

1

FINAL DRAFT
DRAFTING • DESIGN
3424 53rd Avenue East, Bradenton FL 34203
office: 941-752-7574 . fax: 941-752-3344
email: plans@finaldraftinc.com . web: www.finaldraftinc.com

AIBD. American Institute of Building Design

© COPYRIGHT NOTICE

THE FINAL DRAFT INC. HEREBY RESERVES ITS COMMON LAW AND OTHER COPYRIGHTS IN THESE PLANS, IDEAS, DESIGNS, NOTATIONS, TABLES AND ANY ELECTRONIC DATA. THIS INFORMATION IS NOT TO BE COPIED OR CHANGED IN ANY MANNER, NOR IS IT TO BE ASSIGNED TO ANY OTHER PARTY WITHOUT FIRST OBTAINING THE EXPRESSED WRITTEN PERMISSION OF THE FINAL DRAFT INC. VIOLATIONS WILL BE PROSECUTED TO THE FULL EXTENT OF THE LAW.

AS-BUILT FLOOR PLAN FOR:

MELTON LITTLE

433 8th Avenue West
Palmetto, Florida 34221

DRAWN:	G.T.
DATE:	7/7/2021
REVISION:	7/21/2021
SCALE:	AS SHOWN
JOB. NO.	2K21101R1

SHEET
A2

© COPYRIGHT 2020